THIS DRAWING AND SPECIFICATIONS, HEREIN, ARE THE PROPERTY OF DATA GENERAL CORPORATION AND SHALL NOT BE REPRODUCED OR COPIED OR USED IN WHOLE OR IN PART AS THE BASIS FOR MANUFACTURE OR SALE OF ITEMS WITHOUT WRITTEN PERMISSION.

REV.	DESCRIPTION	DRFTG.	APP. BY	DATE
00	RELEASED PER ECO D341			9/19/77
~~C1~~	~~ECO D383~~	~~DD~~ WLS	GMA	5/24/79
02	ECO E436	~~DD~~ WLS	JN	8/28/78
03	ECO 8420		L. POLK - JW	2-15 79

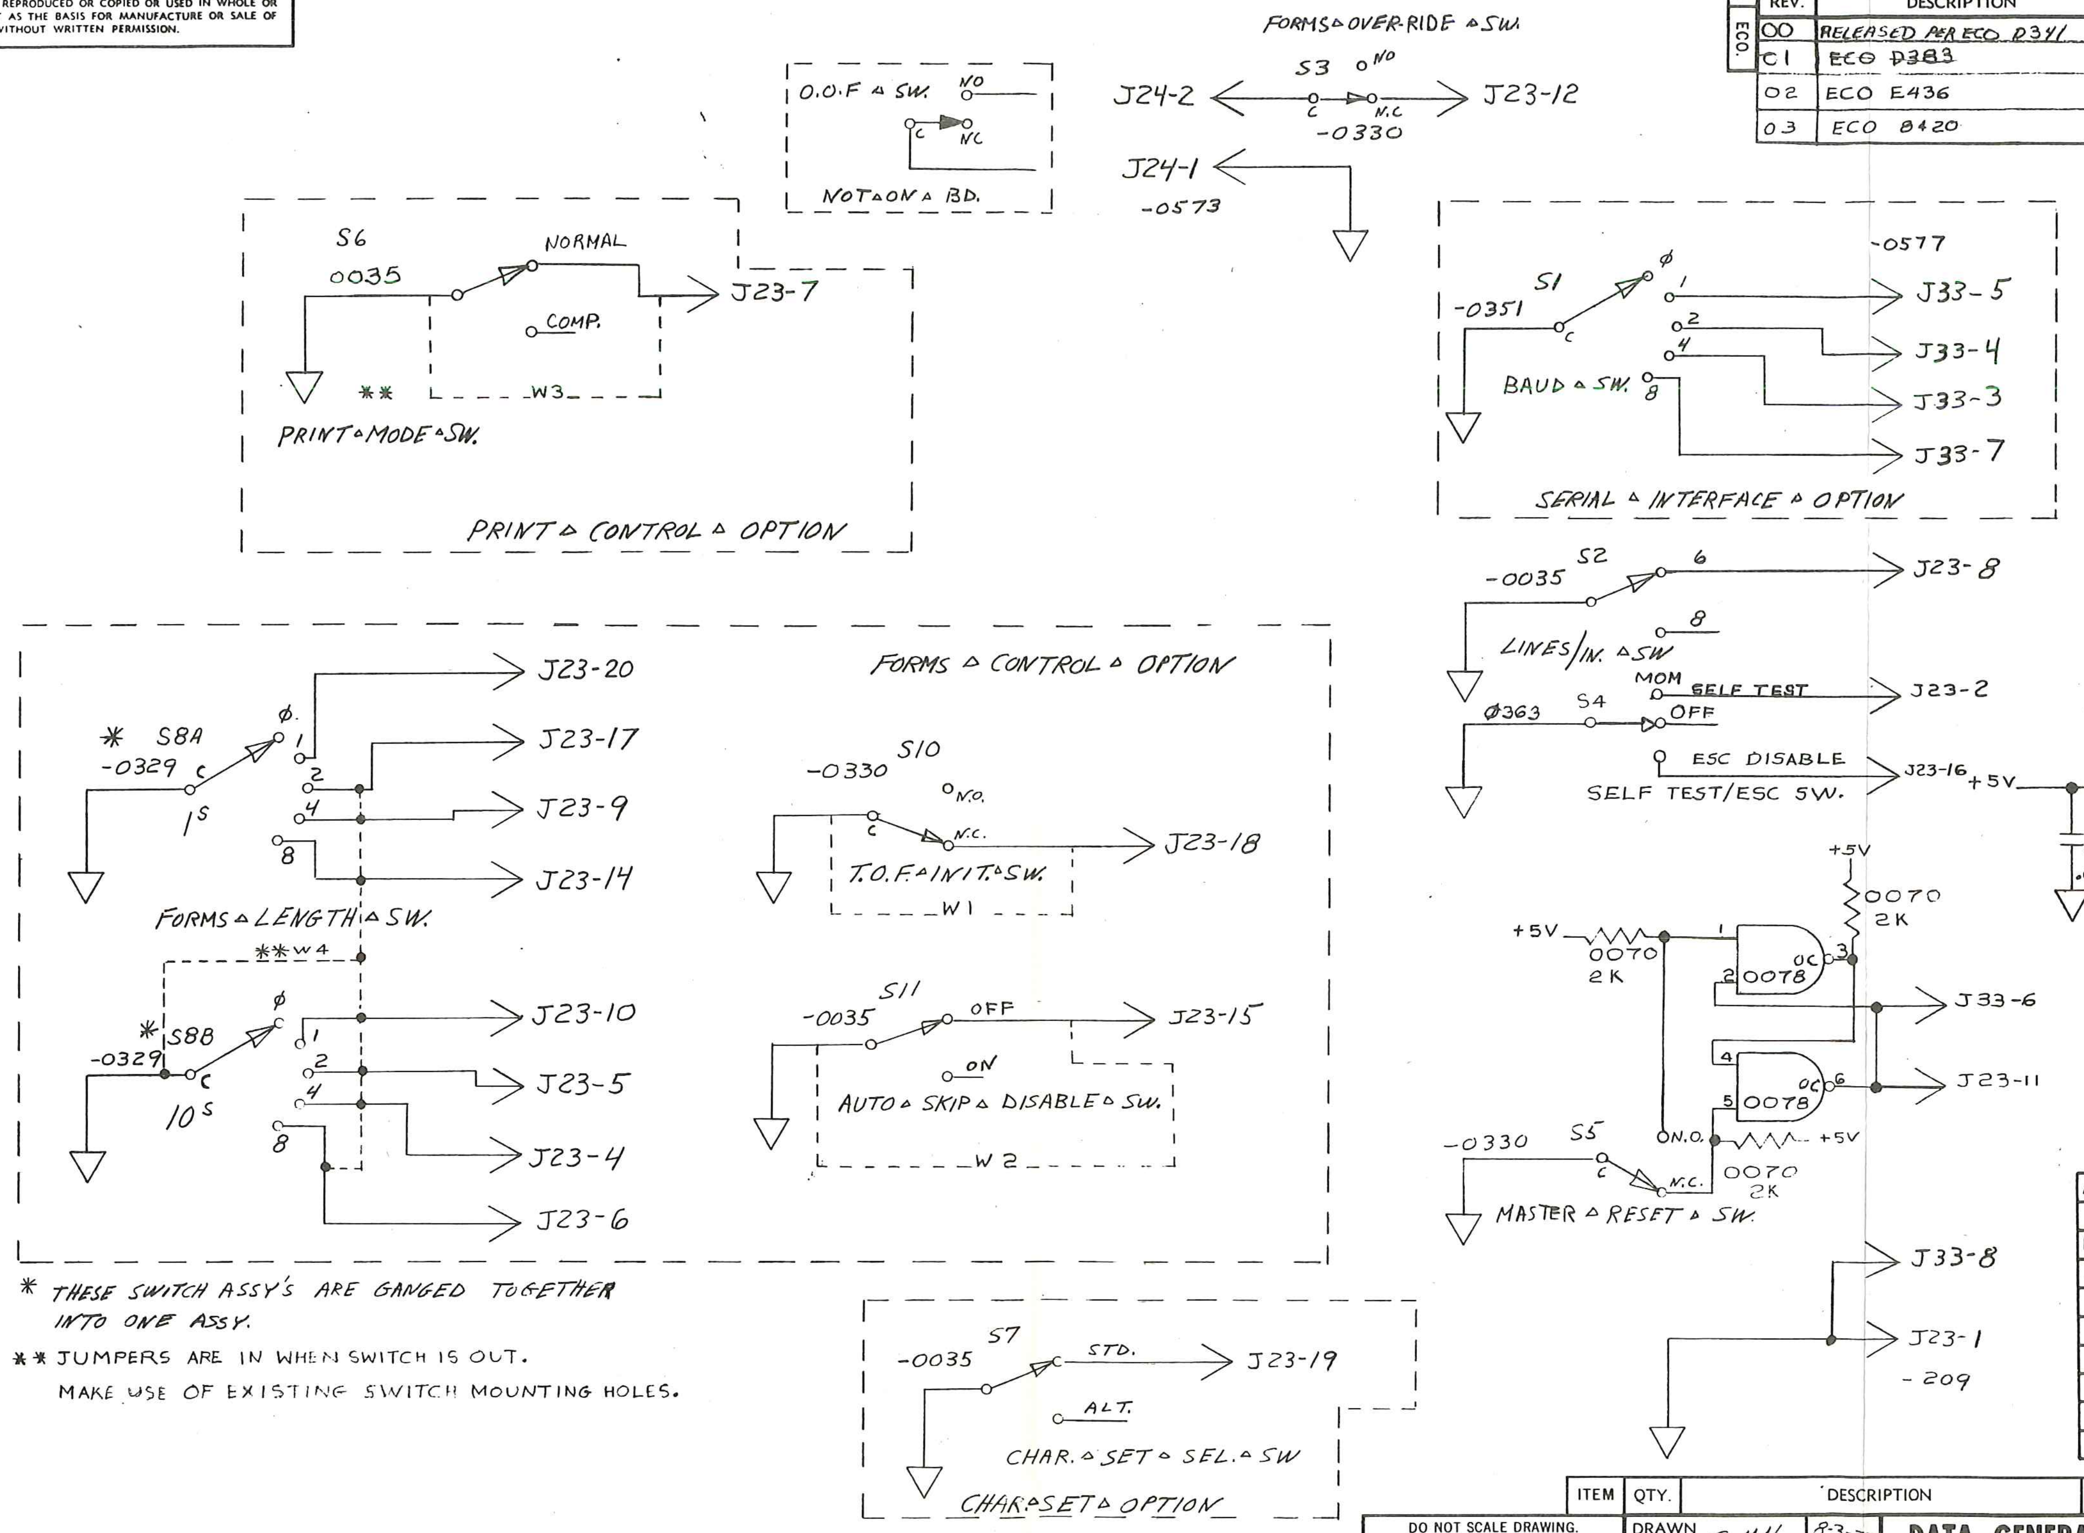
O.O.F ▵ SW.
NO
C
N.C
NOT▵ON▵ BD.
FORMS▵OVER-RIDE ▵SW.
S3
NO
J24-2
J23-12
C
N.C
-0330
J24-1
-0573
S6
0035
NORMAL
J23-7
COMP.
**
W3
PRINT▵MODE▵SW.
PRINT▵ CONTROL ▵ OPTION
-0577
S1
ϕ
-0351
1
J33- 5
2
4
J33-4
C
BAUD ▵ SW.
8
J33-3
J33-7
SERIAL ▵ INTERFACE ▵ OPTION
S2
-0035
6
J23-8
8
LINES/IN. ▵SW
MOM
SELF TEST
J23-2
ϕ363
S4
OFF
ESC DISABLE
SELF TEST/ESC SW.
J23-16
+5V
J23-13
C1
0281
.047uf
+
C2
0002
6.8Mf
FORMS ▵ CONTROL ▵ OPTION
J23-20
* S8A
ϕ.
-0329
C
1
J23-17
1S
2
4
J23-9
8
J23-14
FORMS▵LENGTH▵SW.
**W4
* S8B
ϕ
-0329
1
J23-10
C
2
10S
4
J23-5
8
J23-4
J23-6
S10
-0330
N.O.
C
N.C.
J23-18
T.O.F.▵INIT.▵SW.
W1
S11
-0035
OFF
J23-15
ON
AUTO▵ SKIP▵ DISABLE▵ SW.
W2
+5V
0070
2K
+5V
1
0070
2K
OC
3
2
0078
J33-6
4
OC
6
J23-11
5
0078
N.O.
+5V
-0330
S5
C
N.C.
0070
2K
MASTER ▵ RESET ▵ SW.
J33-8
J23-1
-209
S7
-0035
STD.
J23-19
ALT.
CHAR.▵SET▵SEL.▵SW
CHAR▵SET▵OPTION

* THESE SWITCH ASSY'S ARE GANGED TOGETHER INTO ONE ASSY.

** JUMPERS ARE IN WHEN SWITCH IS OUT. MAKE USE OF EXISTING SWITCH MOUNTING HOLES.

CUT HERE GUARANTEED 2-77

ARTWORK: 107-000-922	
ARTWORK VS SCHEMATIC	
REV	SCHEMATIC REV(s)
02	00,01,02,03

ITEM	QTY.	DESCRIPTION	PART NO.

DO NOT SCALE DRAWING.

UNLESS OTHERWISE SPECIFIED USE D.G.C. SPECIFICATION 108-000028 FOR TOLERANCES AND WORKMANSHIP REQUIREMENTS

MATERIAL

FINISH

DRAWN	G. Miller	8-3-77
CHECKED		
ENGINEER		12/1/77
APPROVED		12/1/77
FIRST USED ON	005-9520	

DATA GENERAL CORPORATION
SOUTHBORO, MASS. 01772

TITLE
COBRA SECONDARY CONTROL PANEL

SCALE	CODE IDENT.	SIZE	CODE	DRAWING NUMBER	REV
	34984	C	001	001224	03

SHEET 1 OF 1

BRUNING 40-536 20411-2

013000837